


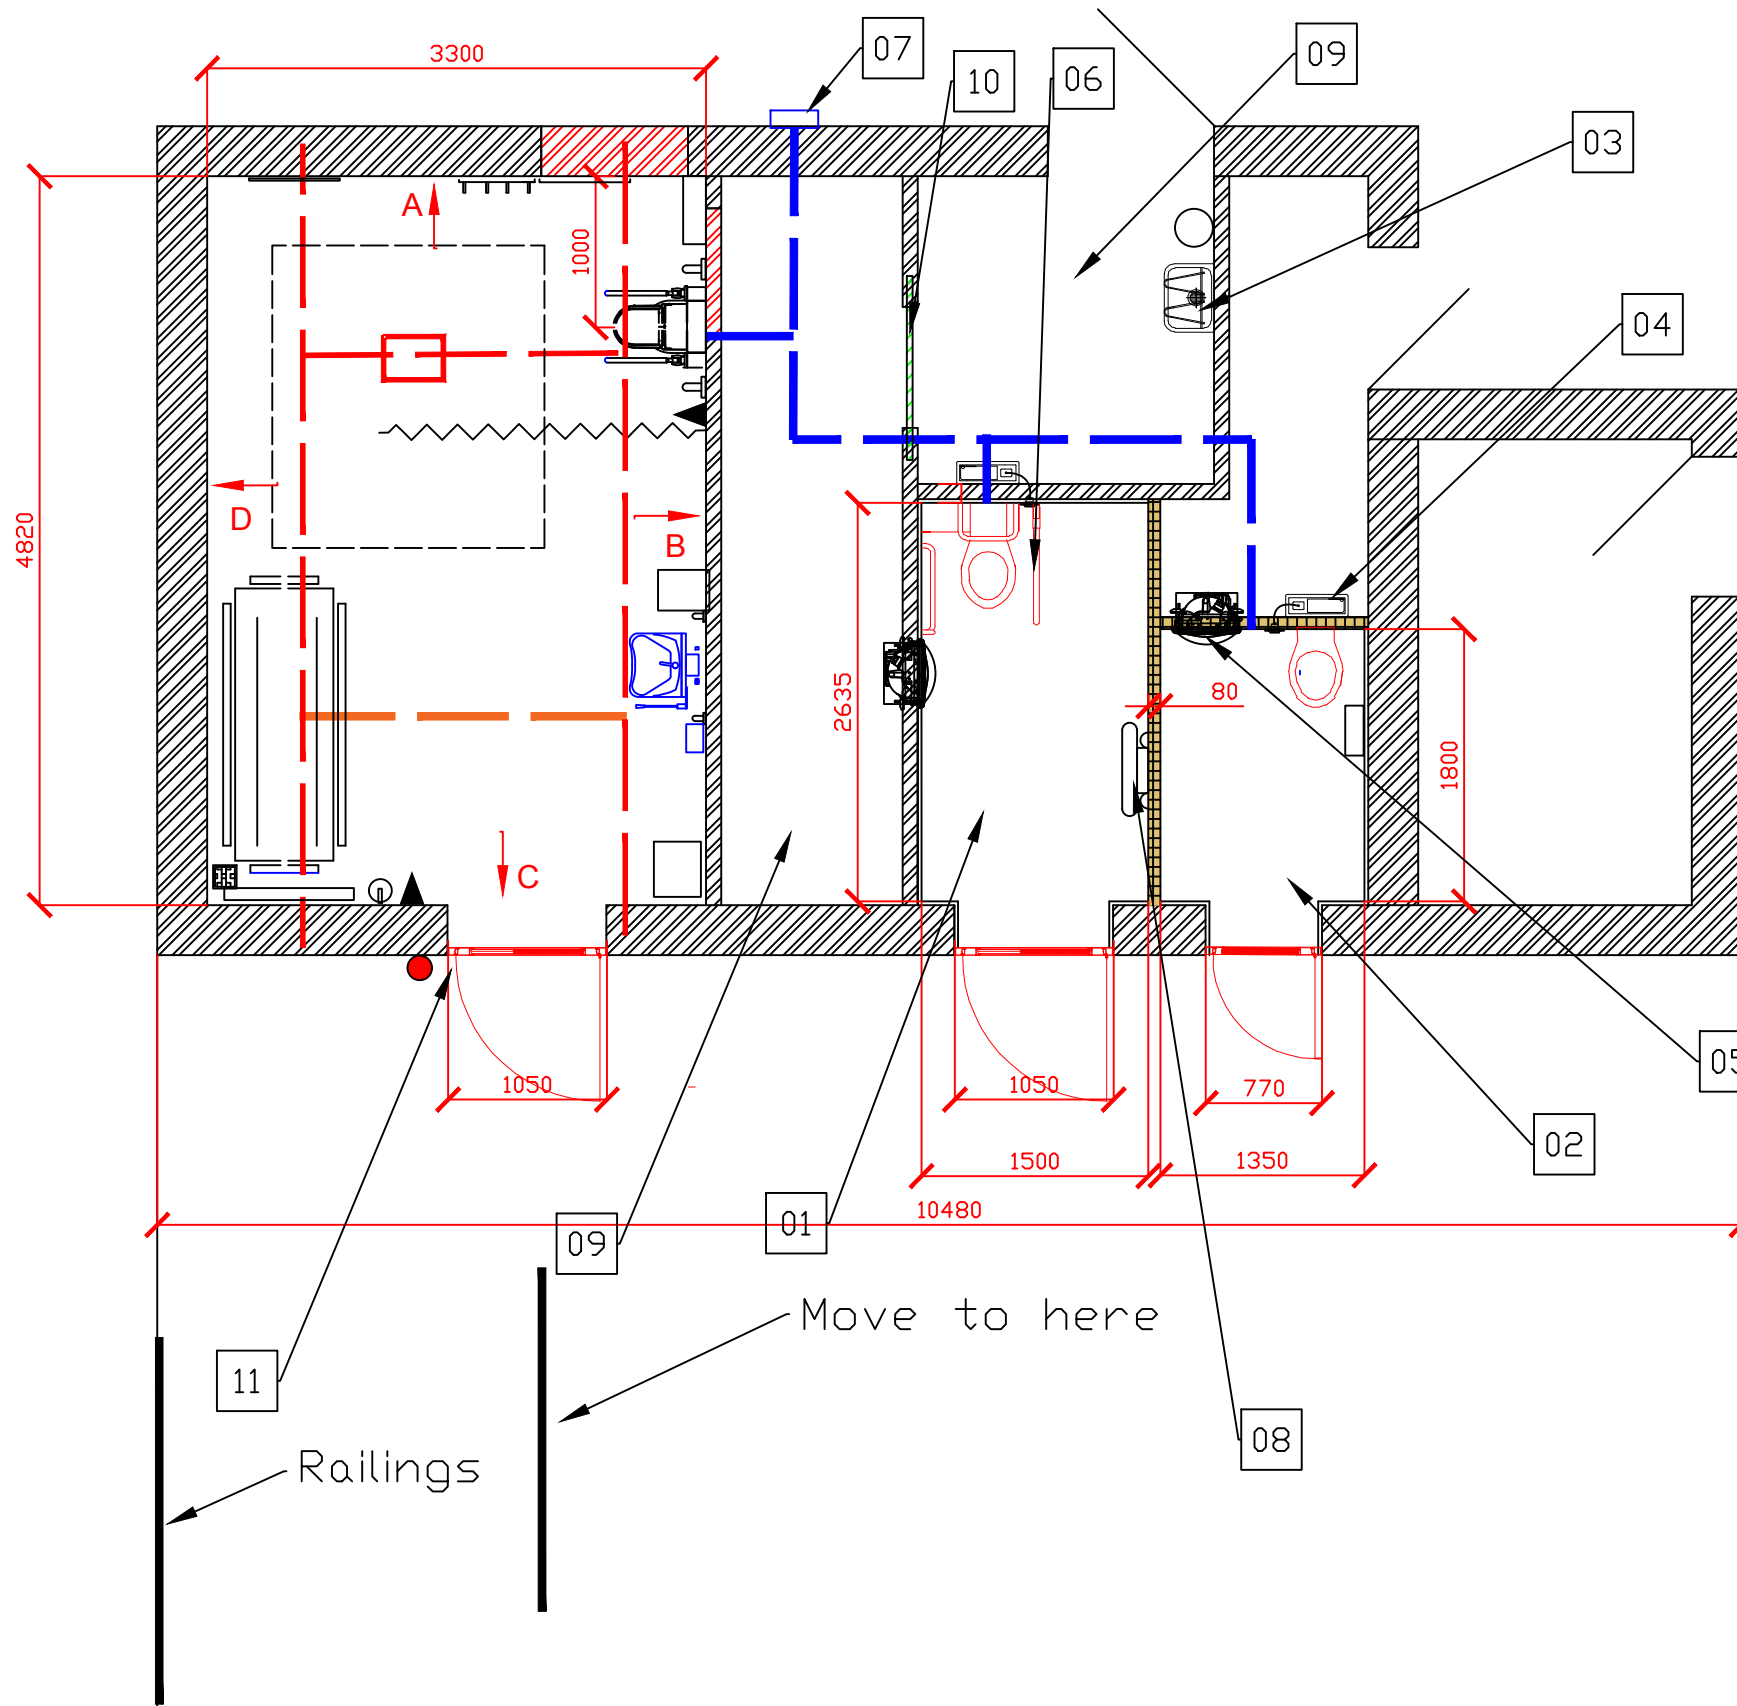
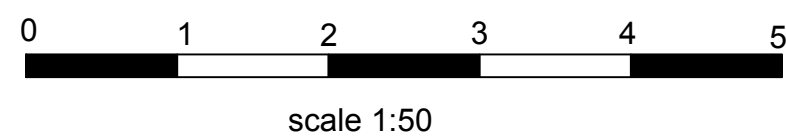



-  EXISTING
-  NEW
-  NEW



- 01 Accessible to part M regs
- 02 Unisex
- 03 Wash down
- 04 Wave on flush
- 05 Handwash/dryer
- 06 Doc M pack
- 07 Extract system
- 08 Baby change
- 09 Service areas
- 10 Cut through with lintel
- 11 Doors on timer



PRELIMINARY DRAWING				ANNING DRAWING		CONSTRUCTION DRAWING		AS-BUILT DRAWING	
Unit C10 Prologis Park Heathrow Corporate Park Green Lane, Hounslow TW4 6ER Tel 02083807371 www.danfo.co.uk						FROME TOWN COUNCIL TOILET REFURBISHMENT VICTORIA PARK FROME			
DRAWN BY		PROJECT NO		SCALE 1:50		FORMAT A3		REV	
DATE MAY 2022		DRAWING NUMBER DFO-FDC-VPF-02		REV					